

MEMAR
CONSULTANTS INC.

Virtual Plan

This Product is Prepared by
"Memar Consultants Inc."
Using Laser Technology
T: 416-575-4448

<http://www.MemarConsultants.com>

NOTES:

All efforts are made to prepare the most accurate product. However this product should be considered as an estimate. Call for details.

Memar Consultants Inc. has the full copy right and ownership of this product and any re use of this product or part of it for any purpose including future listing of the property or, future copy or use of this product by any means, by anyone including existing and future agents, owners, contractors, designers, architects and/or any profession/professional is subject to fees and agreement with Memar Consultants Inc. Please contact us for details on how you can receive a digital copy in available formats for this building or other buildings.

Gross Floor Area:

1,432 FT²

DRAWING TITLE:

Basement Floor Plan

SCALE:

3/16" = 1'-0"

ADDRESS:

31 Chadburn Crescent, Aurora



VERSION:

1.0

DATES:

21/09/2009

A.01

NOTES:

All efforts are made to prepare the most accurate product. However this product should be considered as an estimate. Call for details.

Memar Consultants Inc. has the full copy right and ownership of this product and any re use of this product or part of it for any purpose including future listing of the property or, future copy or use of this product by any means, by anyone including existing and future agents, owners, contractors, designers, architects and/or any profession/professional is subject to fees and agreement with Memar Consultants Inc. Please contact us for details on how you can receive a digital copy in available formats for this building or other buildings.

Gross Floor Area:
1,459 FT²

DRAWING TITLE:


Ground Floor Plan

SCALE:

3/16" = 1'-0"

ADDRESS:

31 Chadburn
Crescent, Aurora

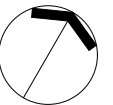


VERSION:


1.0

DATES:

21/09/2009

A.02

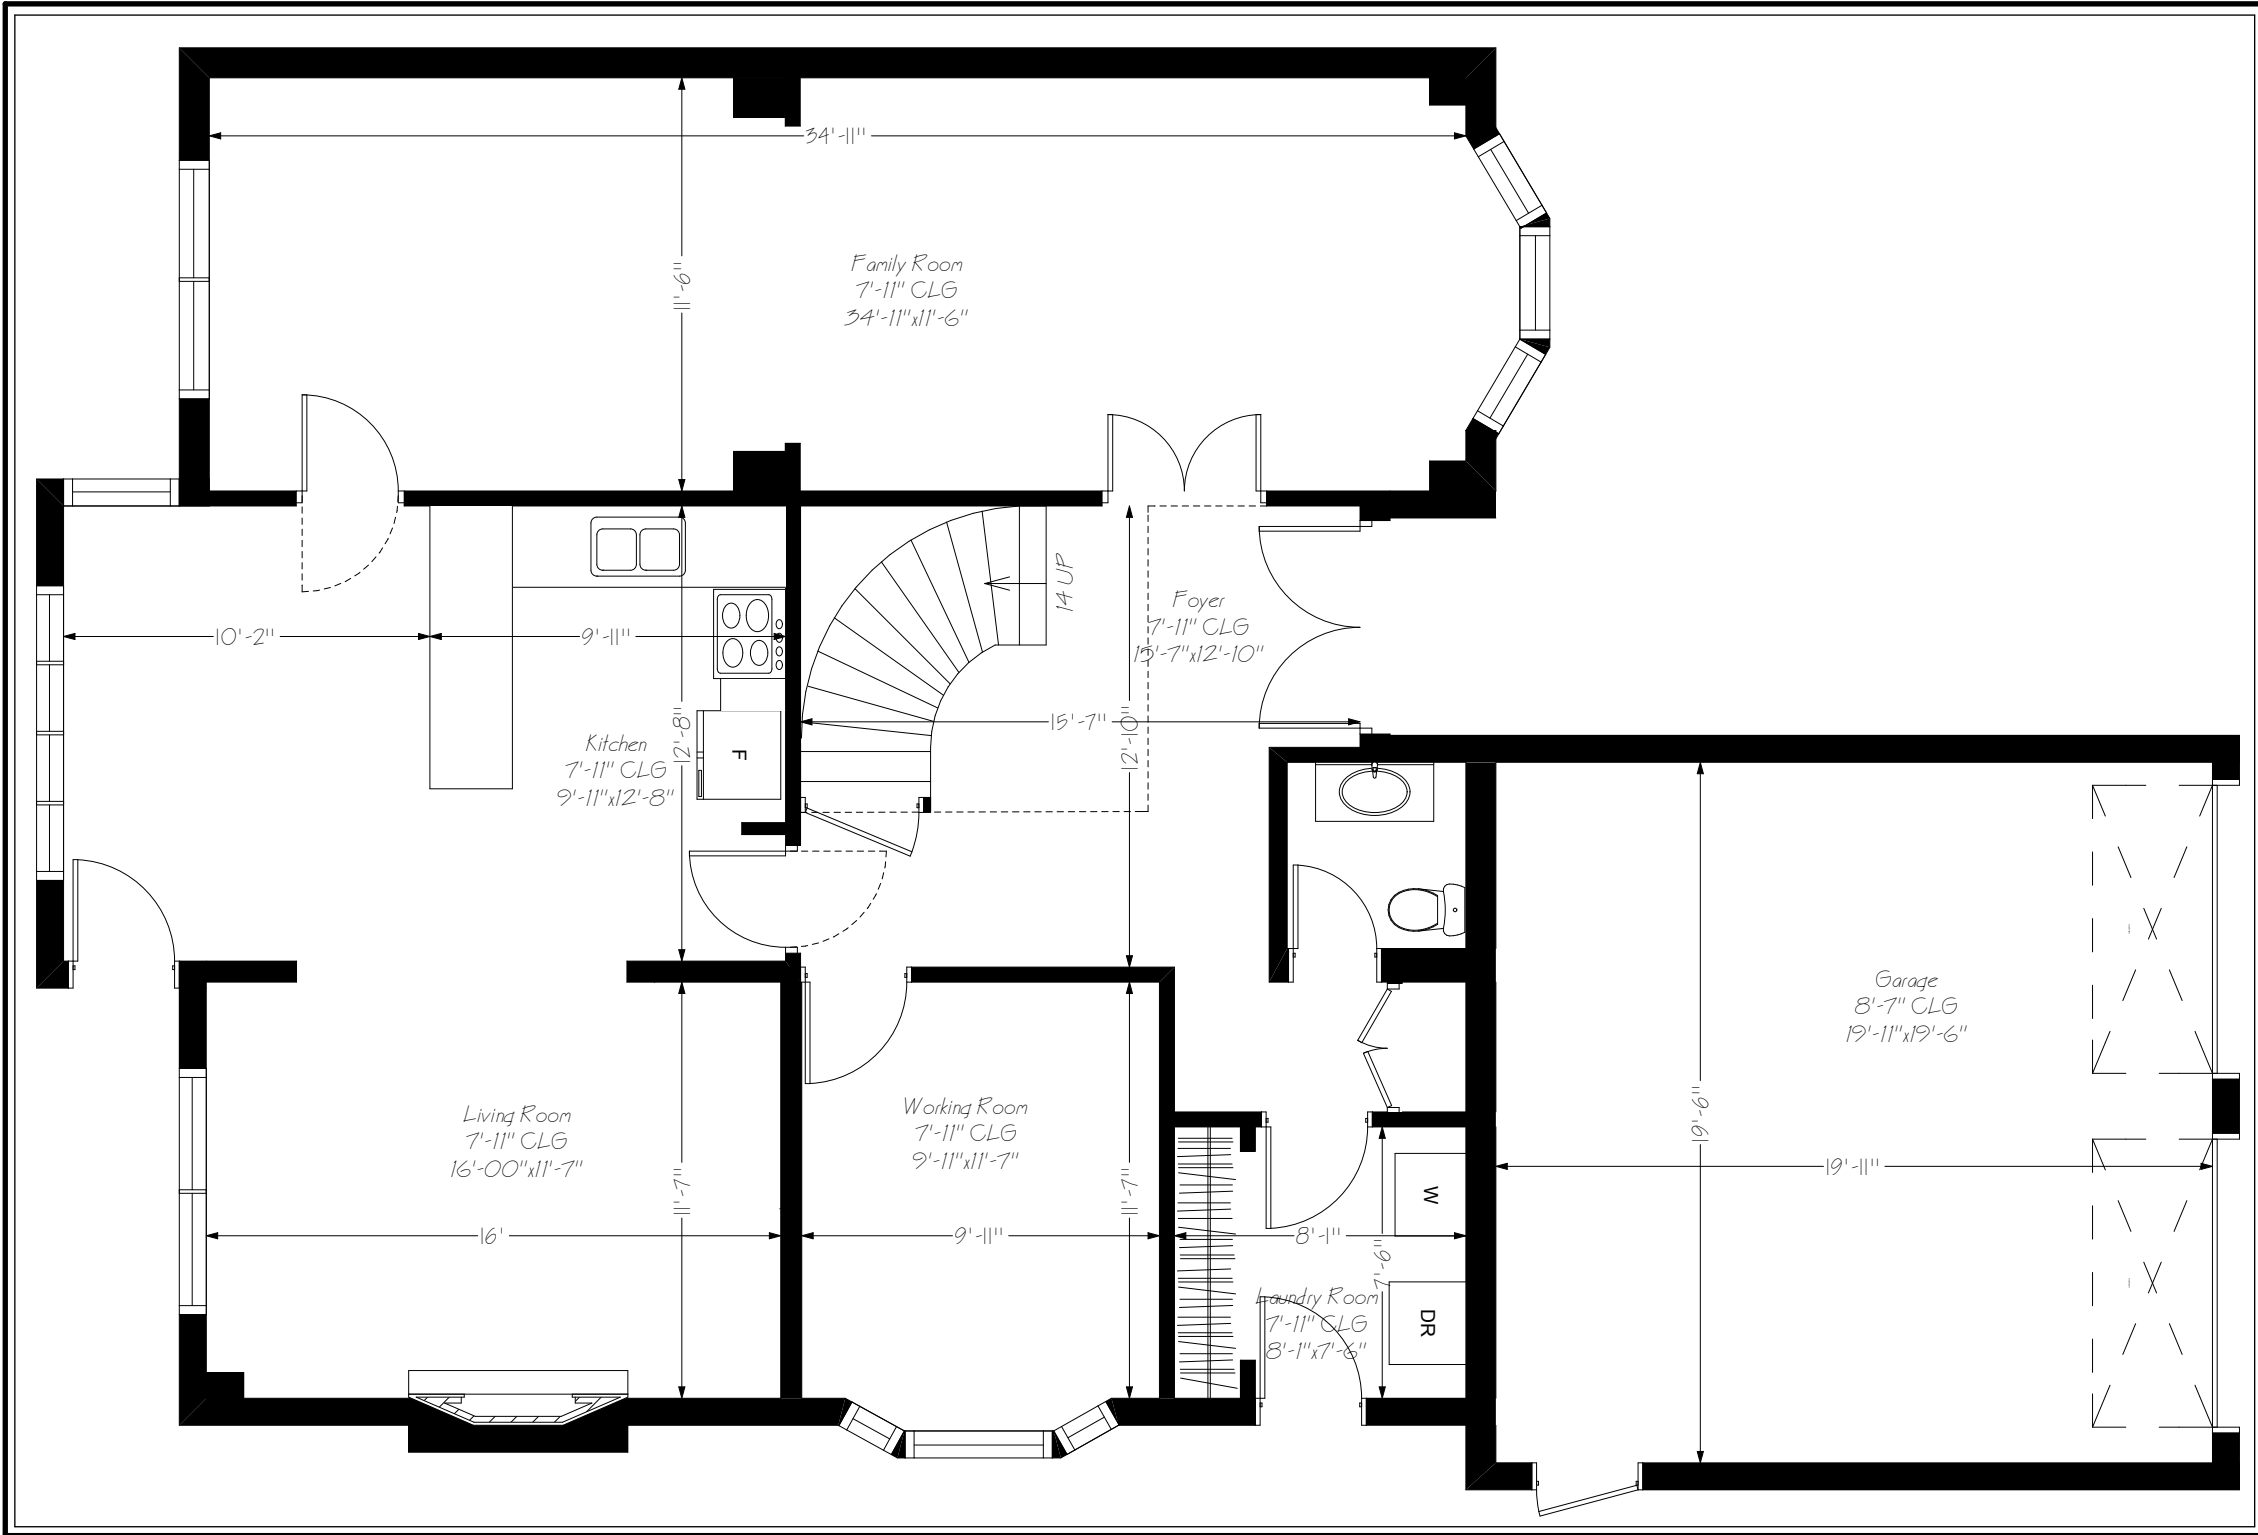

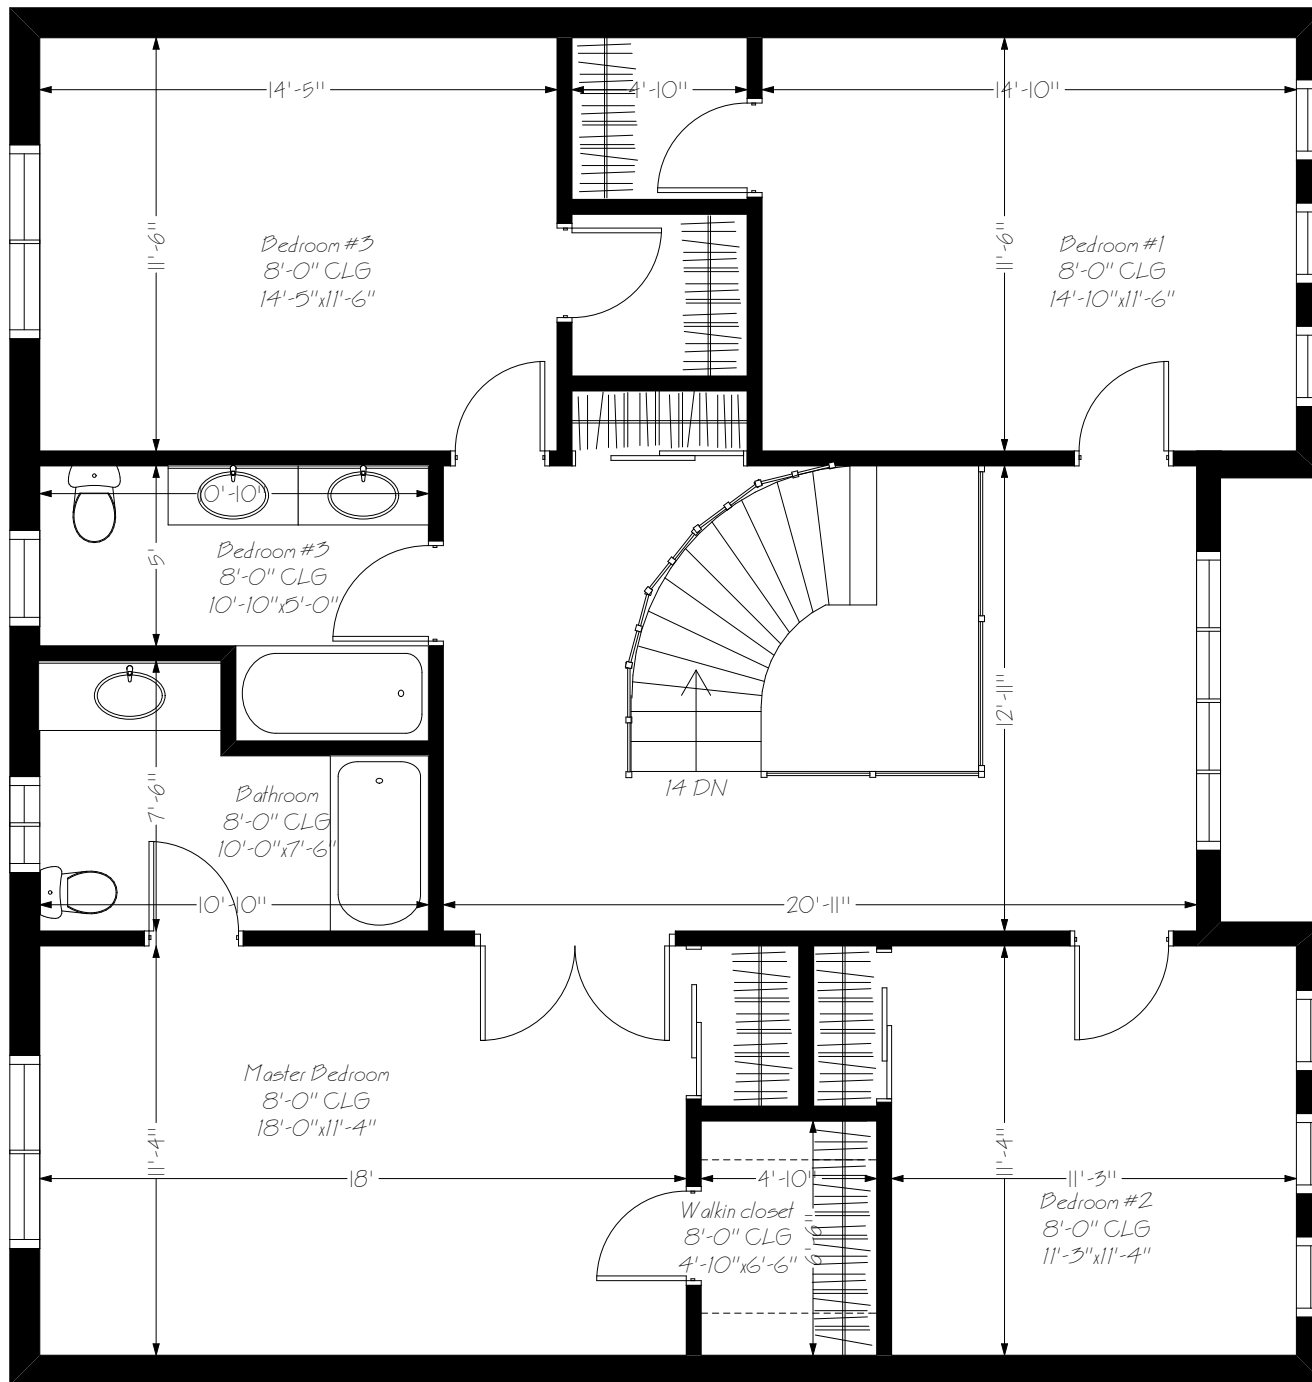

NOTES:
All efforts are made to prepare the most accurate product. However this product should be considered as an estimate. Call for details.

Memar Consultants Inc. has the full copy right and ownership of this product and any re use of this product or part of it for any purpose including future listing of the property or, future copy or use of this product by any means, by anyone including existing and future agents, owners, contractors, designers, architects and/or any profession/professional is subject to fees and agreement with Memar Consultants Inc. Please contact us for details on how you can receive a digital copy in available formats for this building or other buildings.

Gross Floor Area:
1,364 FT²

DRAWING TITLE:
2nd Floor Plan

SCALE:
3/16" = 1'-0"

ADDRESS:
31 Chadburn
Crescent, Aurora



VERSION:
1.0
DATES:
21/09/2009

A.03